


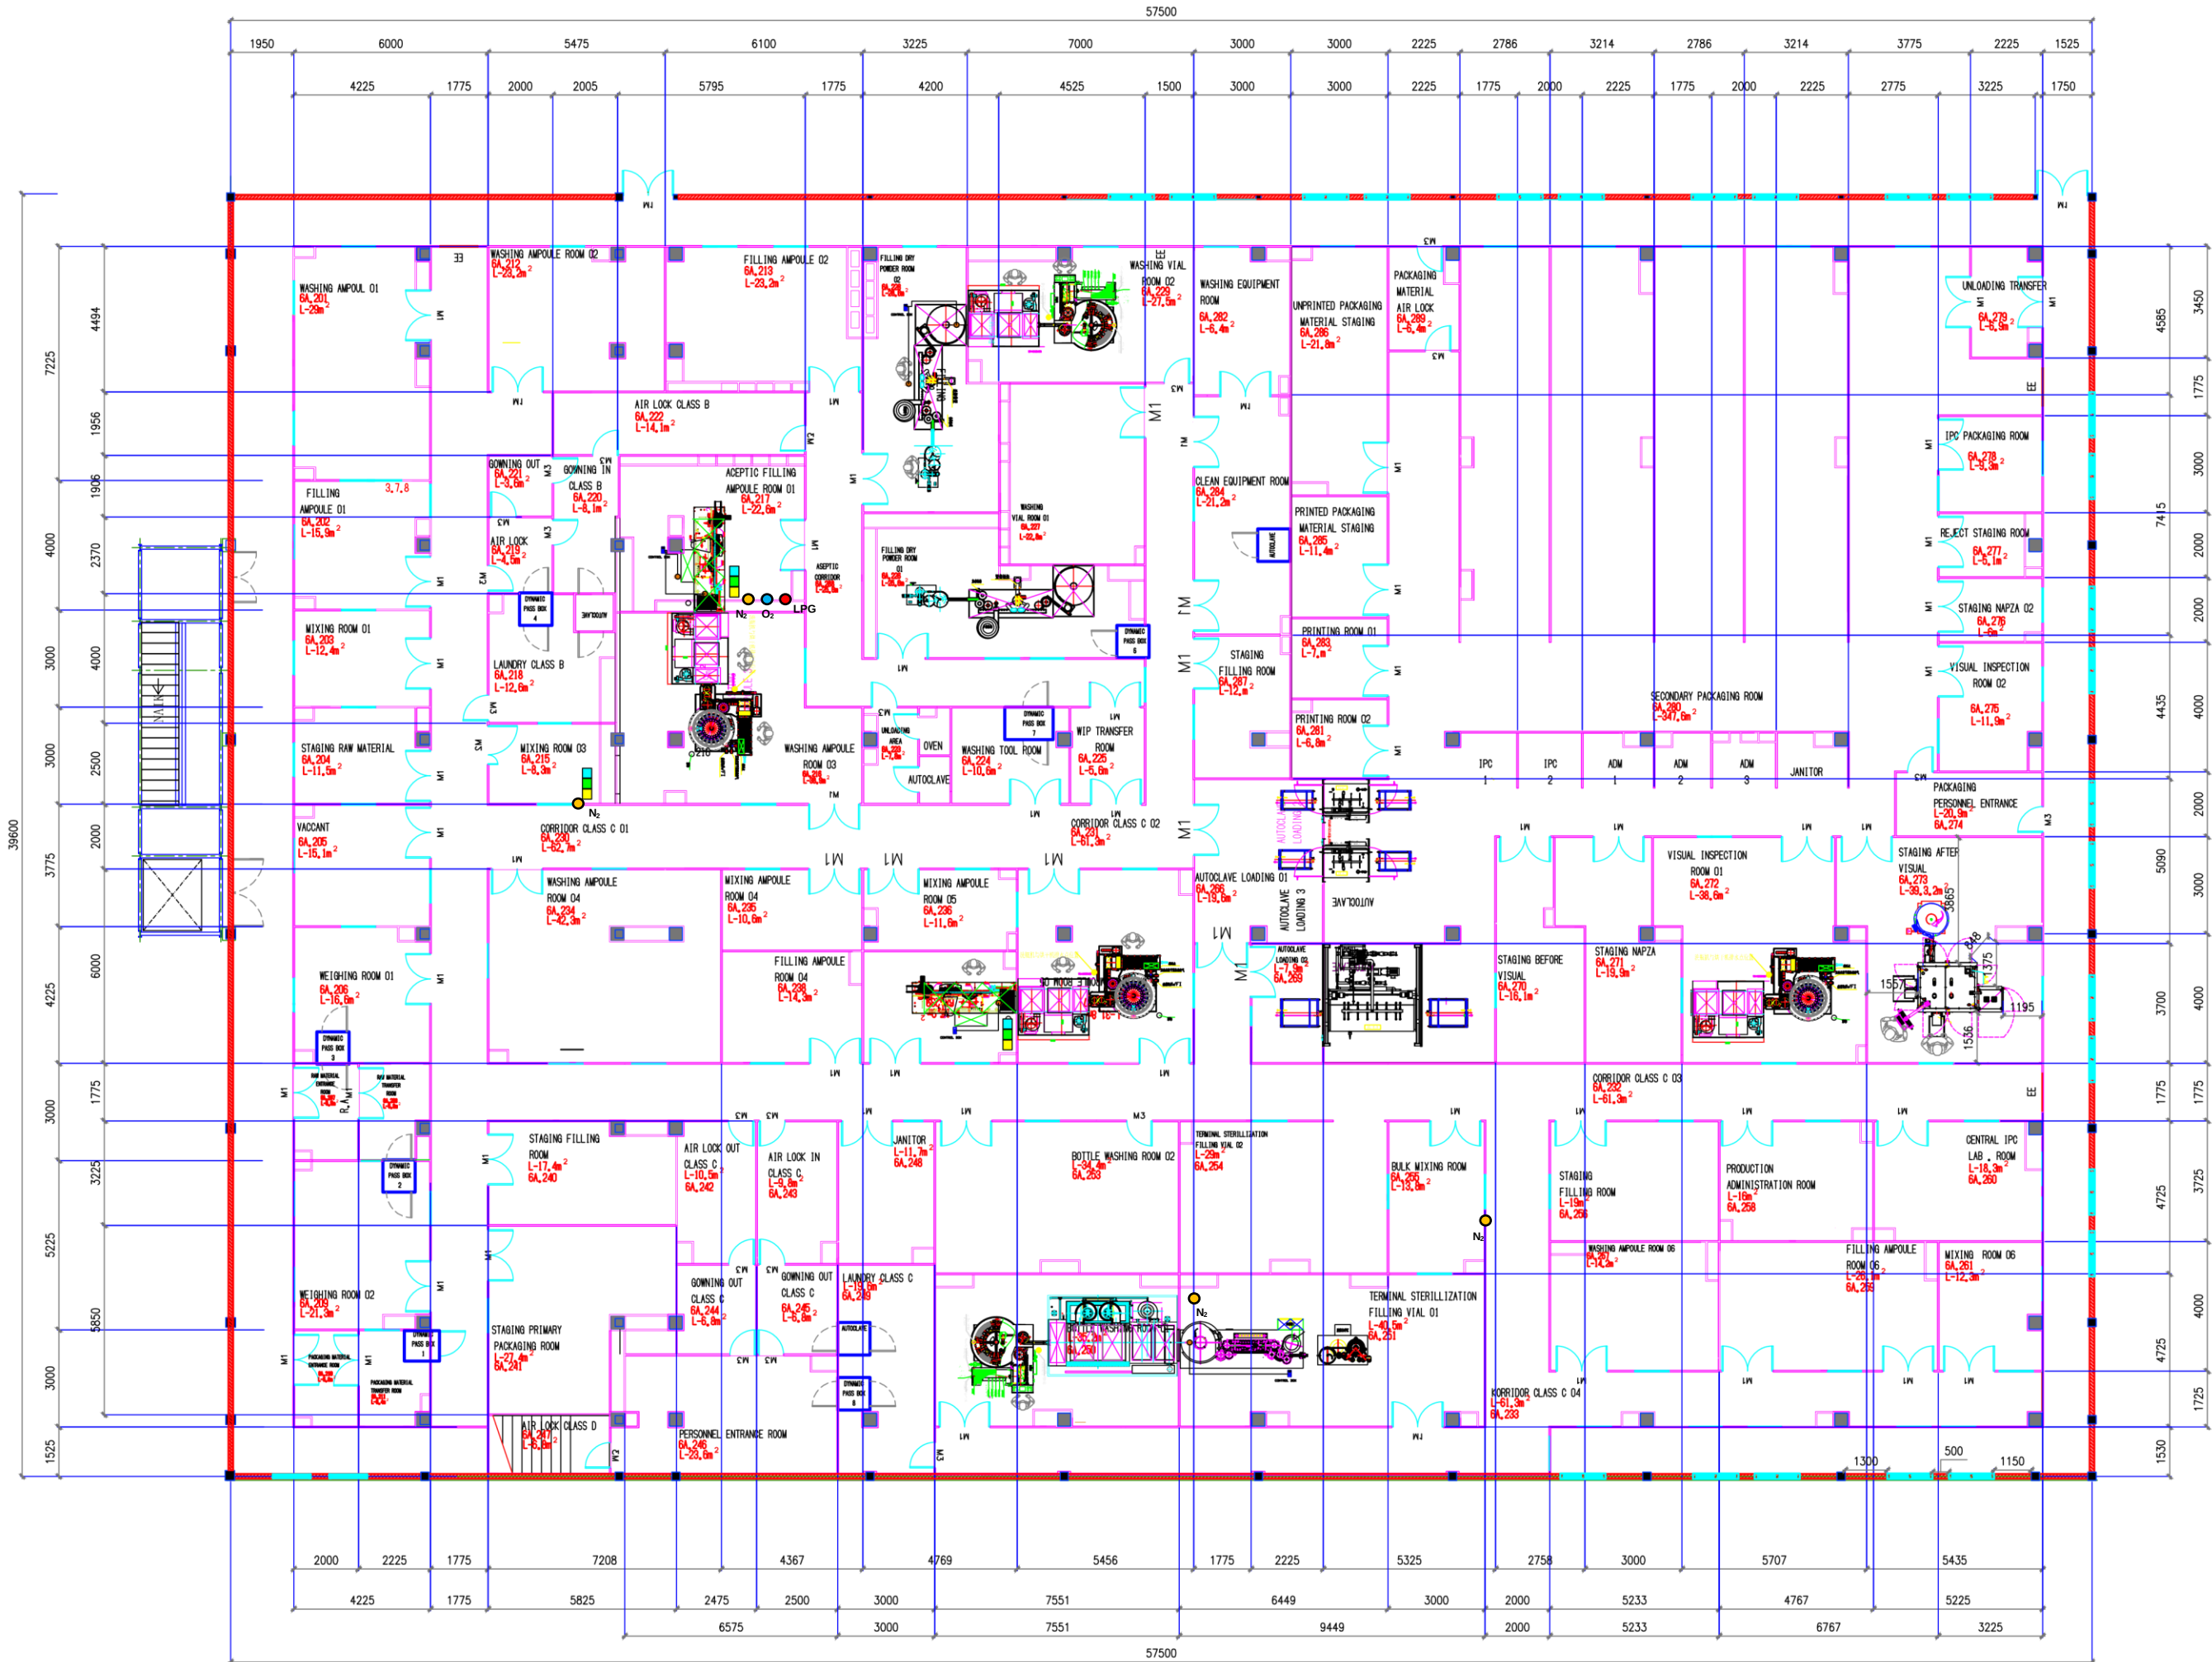

LAYOUT UNIT 6A

SKALA : 1:100

LOKASI LOCATION			
KETERANGAN LEGEND			
N/A			
NO. REFERENSI REFERENCE NUMBER			
01 D-A-L-MF.L1-001			
02 D-A-L-U6S.L2-001			
NO. TANGGAL REVISION			
01 14/06/2024 -NOMOR USULAN PERUBAHAN 335/MFG/PR/PP/VI/24			
Deskripsi revisi : -PENAMBAHAN MESIN INJEKSI VISUAL AMPOUL DI UNIT 1 STERIL DAN MESIN INSPEKSI VISUAL BOTOL DI UNIT 6A			
N/A			
MANUFATUR			
 Good Quality Improves Life's Quality SUKABUMI-CEKEMBAR			
STATUS GAMBAR DRAWING STATUS			
AS BUILT DRAWING			
JUDUL GBR. DRAWING NUMBER			
LAYOUT UNIT 6A			
PROJECT			
UNIT 6			
PARAF INITIALS			
TANGGAL DATE			
UKURAN SIZE			
A3			
DIGAMBAR DRAWN			
DIPERIKSA CHECKED			
DISETUUJI APPROVED			
SKALA SCALE			
N.T.S			
DISETUUJI APPROVED			
DISETUUJI APPROVED			
NO. GAMBAR DRAWING NUMBER			
REV.			
D-A-L-U6S.L2-002			
01			